


2 pcs 4.5" carbon-carbon rods, # BNLCC01 & BNLCC02

- Thorlabs B1224 breadboard
- Thorlabs PH3-ST Post Holder
- Thorlabs TR6 Post
- Thorlabs R2 post stop (not shown)
- Edmund L36-605 adjustable ring mount

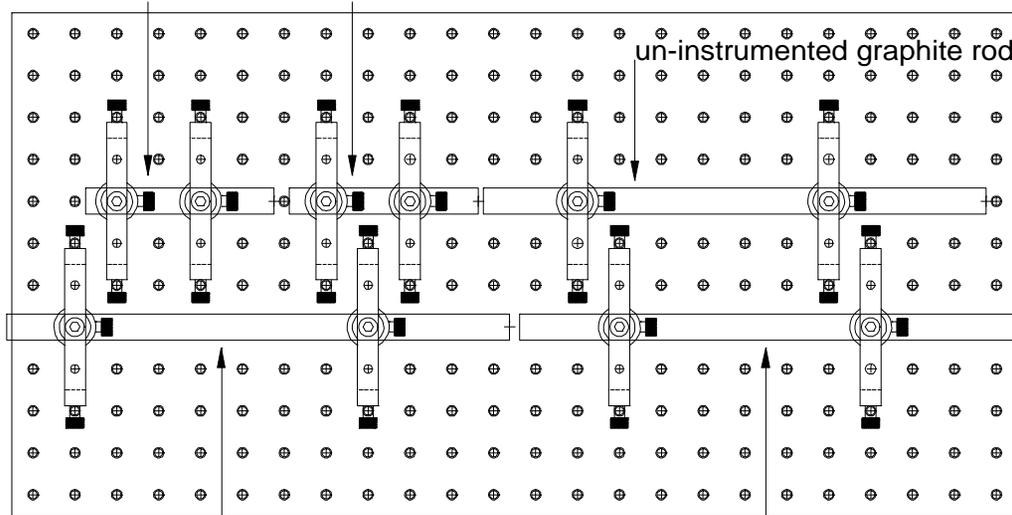



Box #1, Line #2, entrance end

Box #1, Line #1, entrance end

24.000in.

instrumented graphite rod, type ATJ, # BNL02

instrumented graphite rod, type ATJ, #BNL01

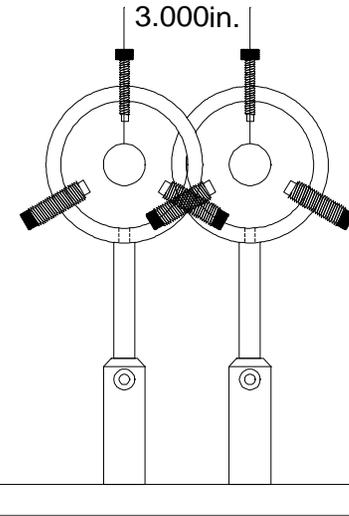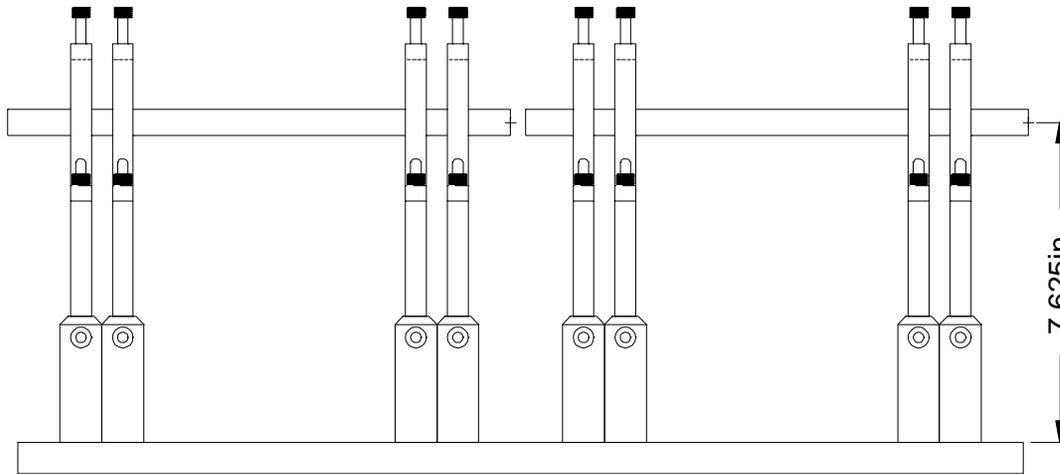

approved by:

reviewed by:

drawn by : C. Finrock

Carbon Rod Mounts in box #1

As Built for use in A3 line

E-951 Muon Muon Collider Targetry

AGS Job number: D13-0M-127

drawing number: D13-M-7176-1

date : 3/18/01

Rev. : 0