


Actuator Air (60 psig)

Computer Controlled  
Pilot Valves

5/8/01 changed positions of  
components in containment to  
reflect the as-built configuration

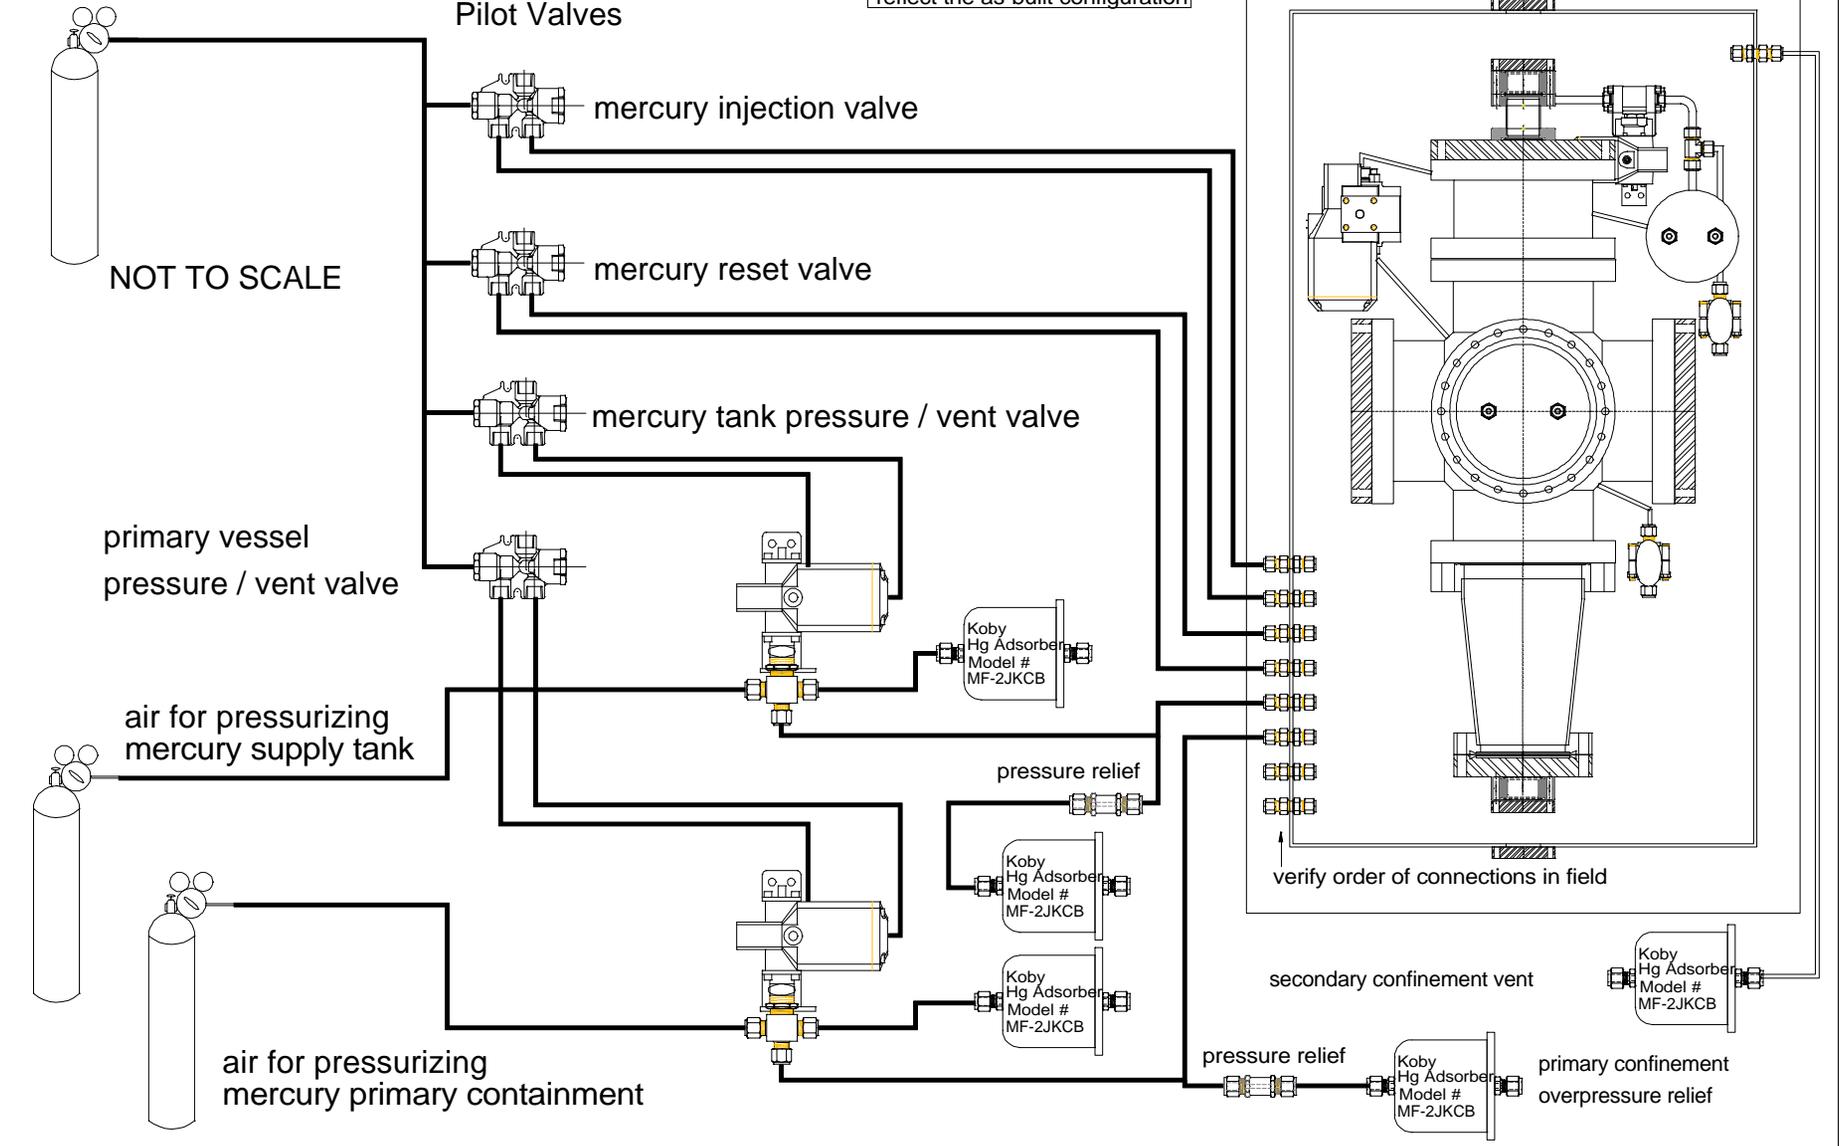

approved by:

reviewed by:

drawn by : C. Finrock

# Schematic of Plumbing System

## Mercury Jet Target

E-951 Muon Muon Collider Targetry

AGS Job number: D-13-0M-127

drawing number: D-13-M-7184-1

date : 1/4/01

Rev. : 1